




POGLED NA DESNI BOK

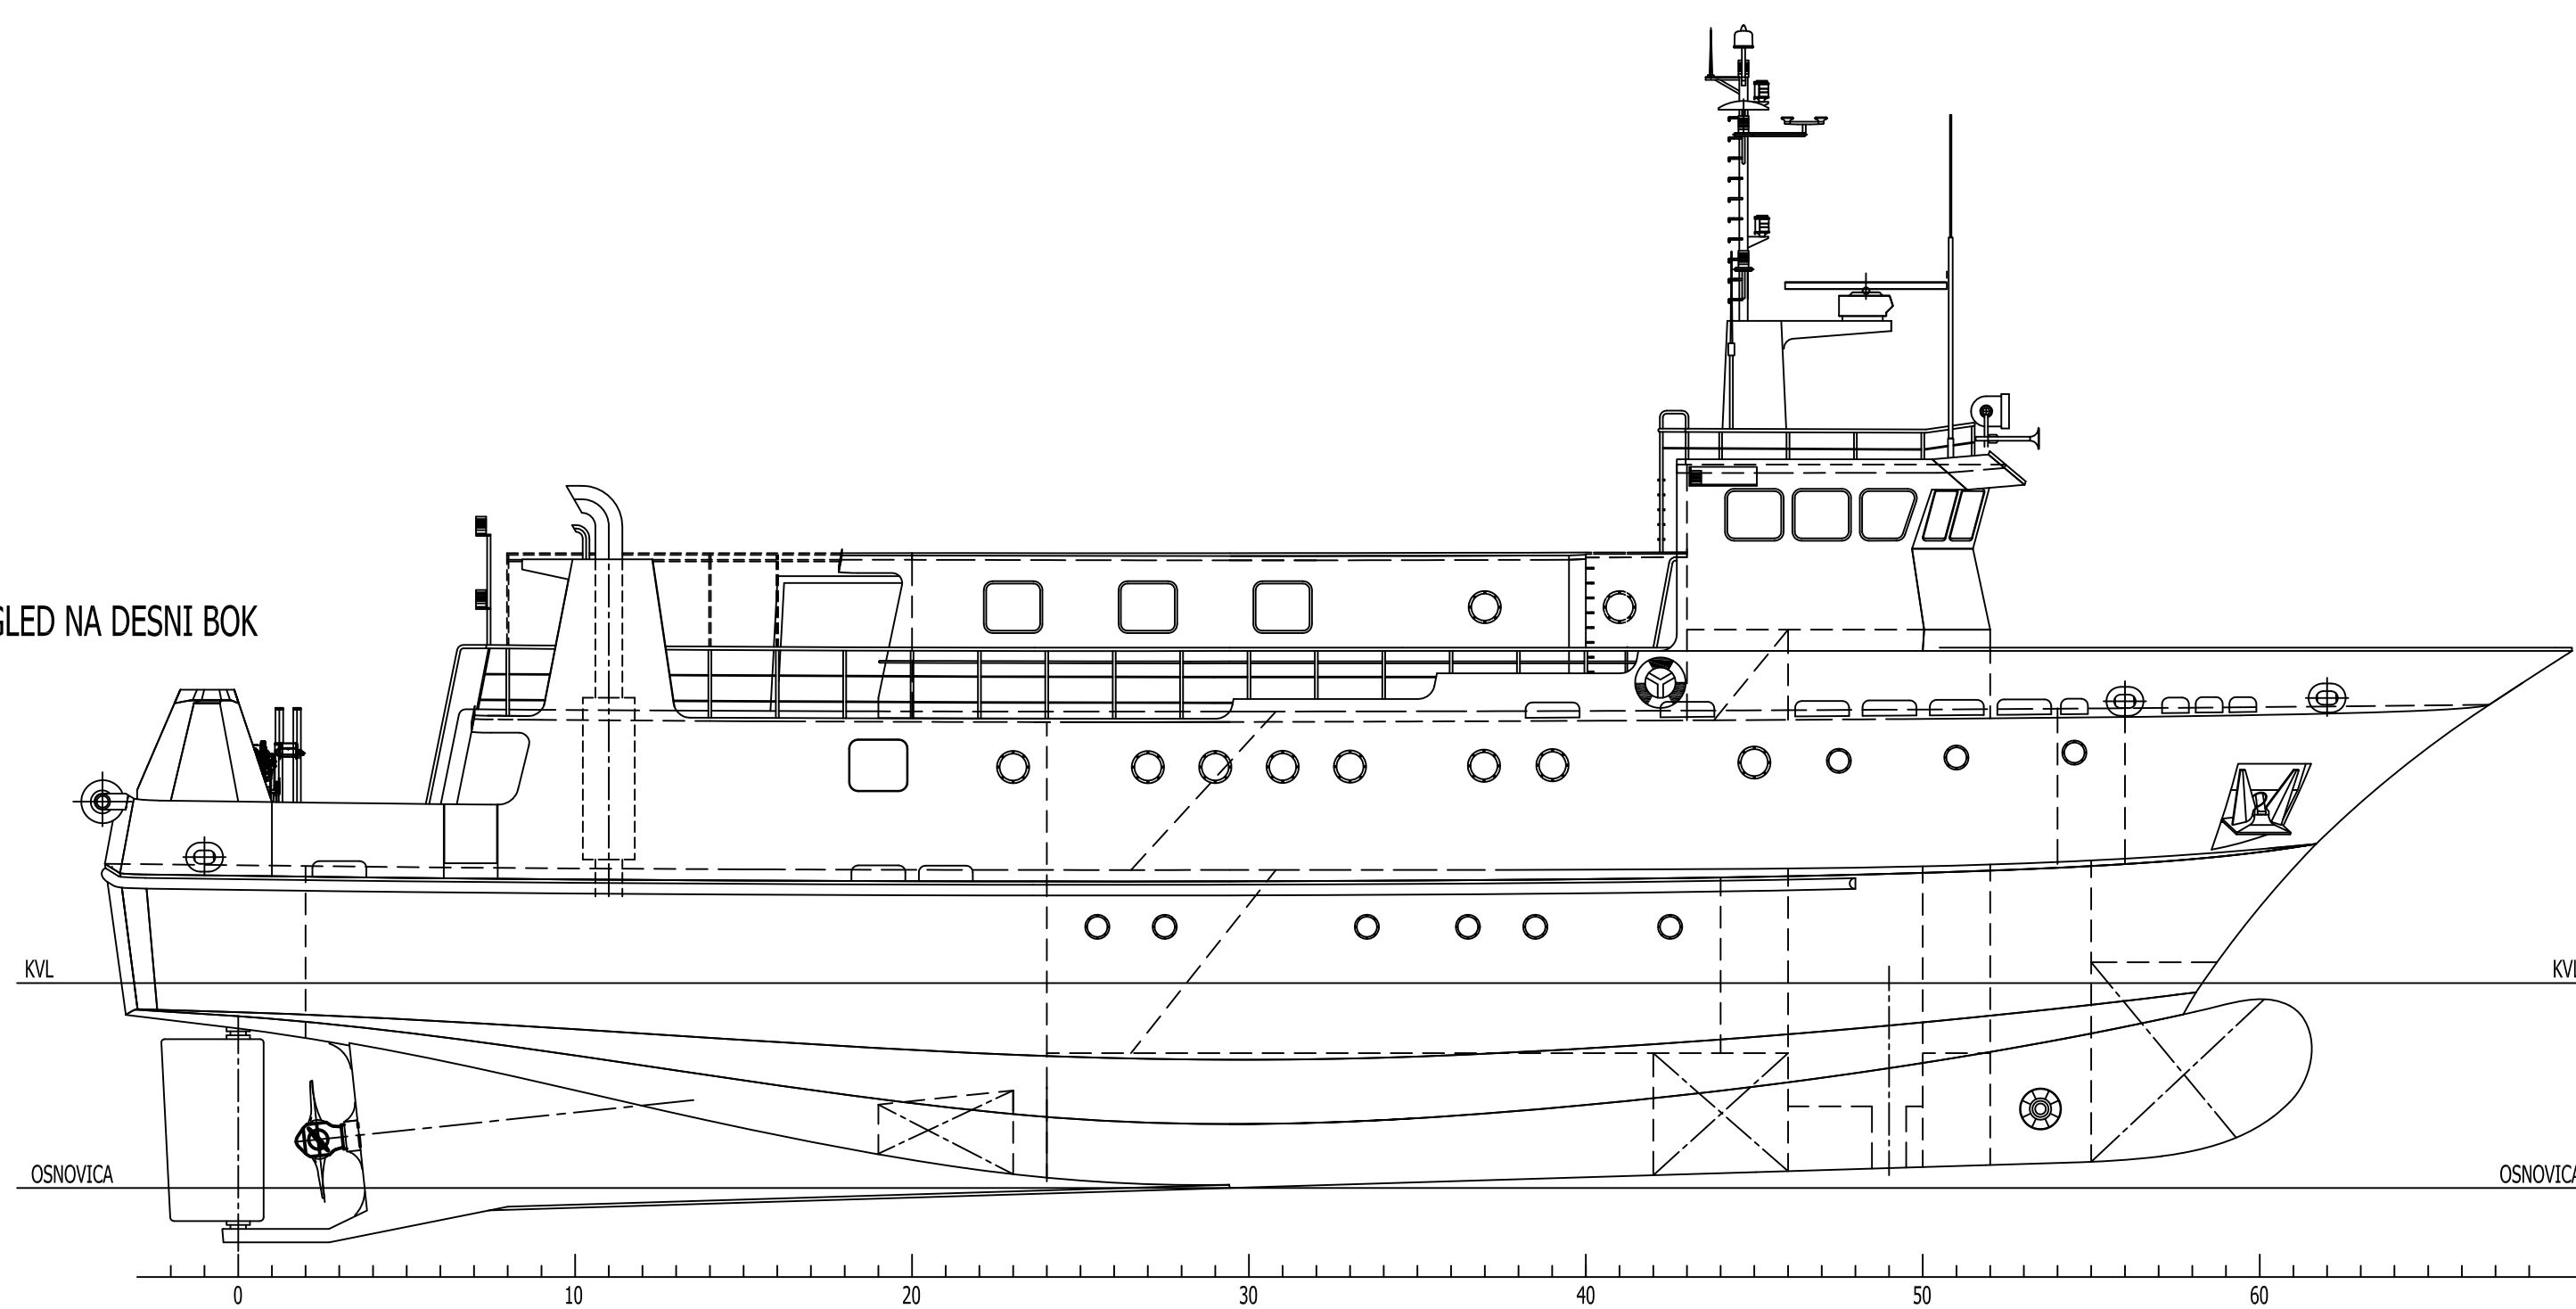


POGLED ODOZGO

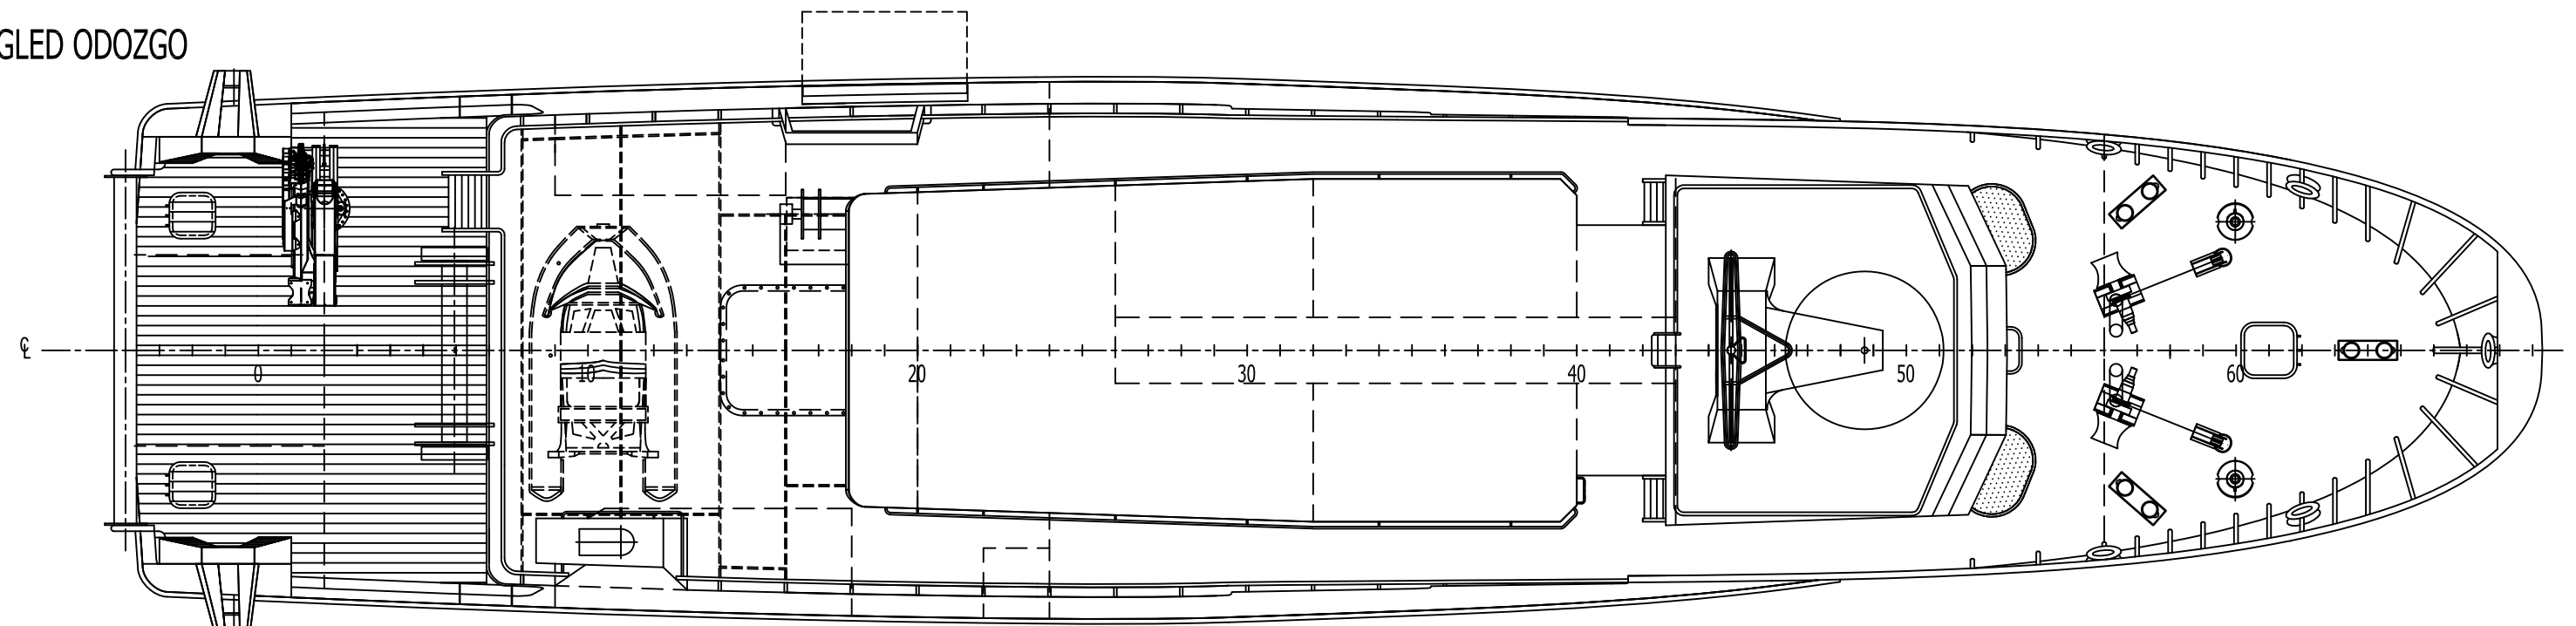


PALUBA KAŠTELA

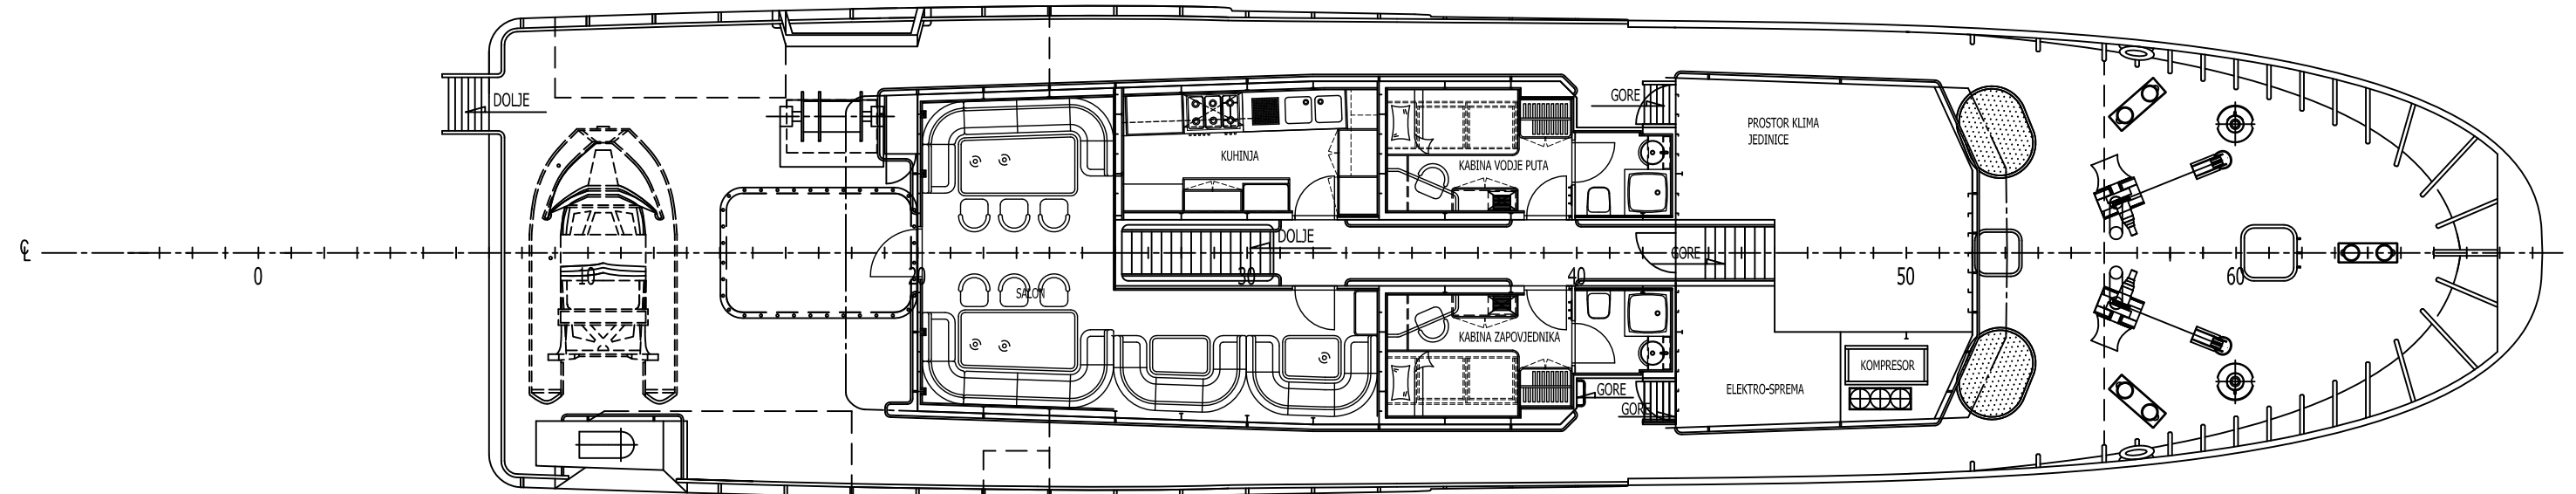


KORMILARNICA

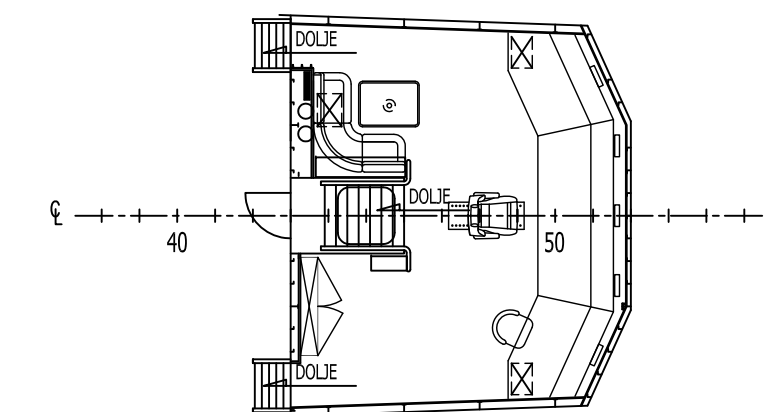


GLAVNA PALUBA

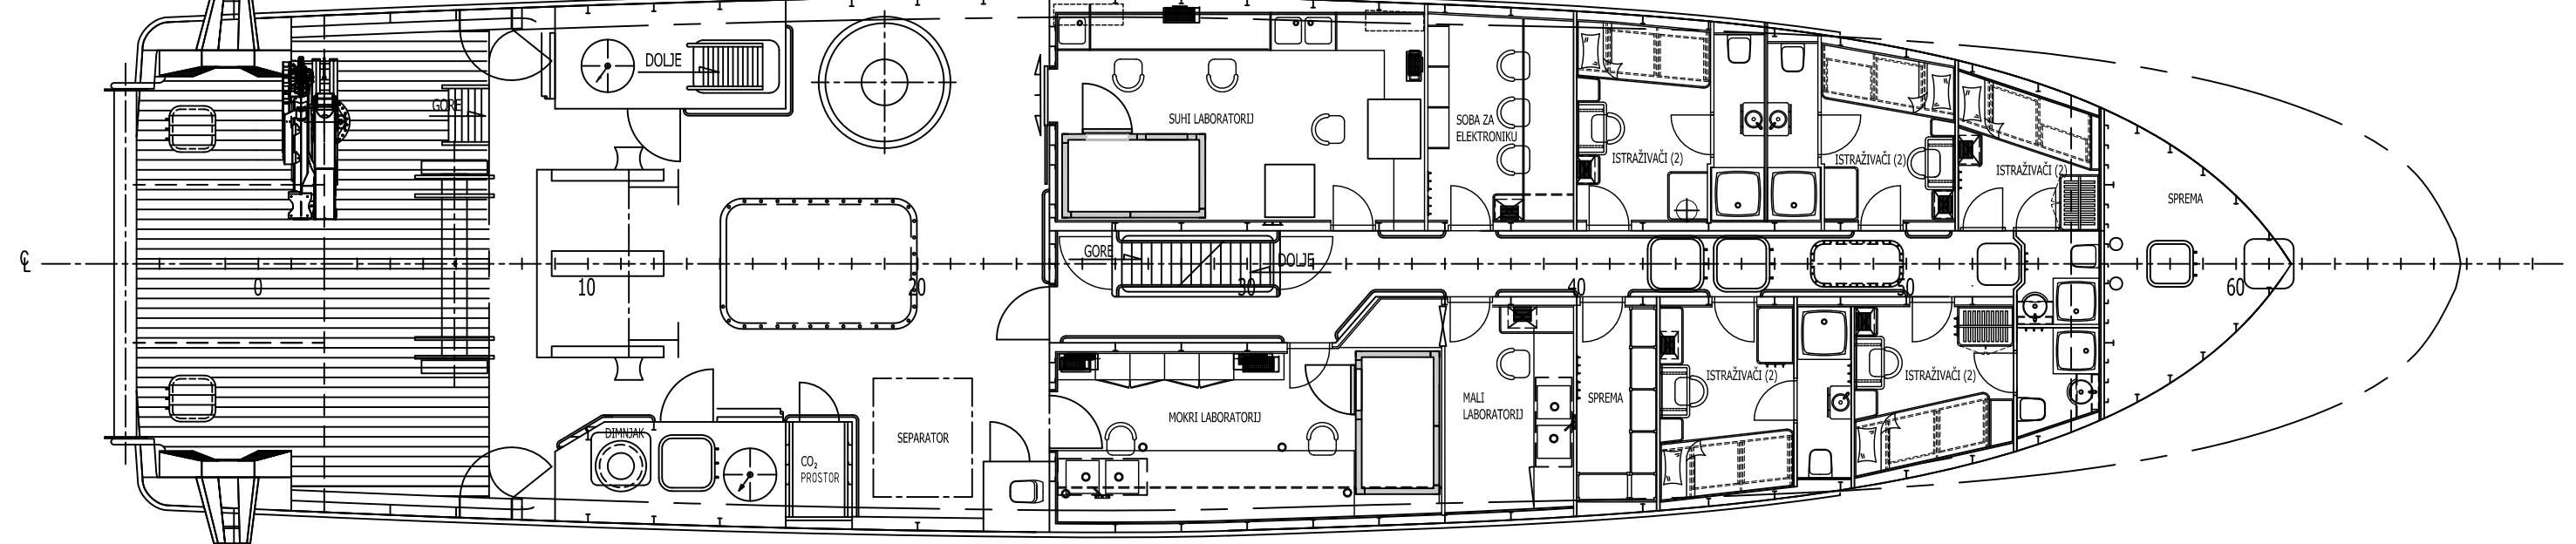

DONJA PALUBA

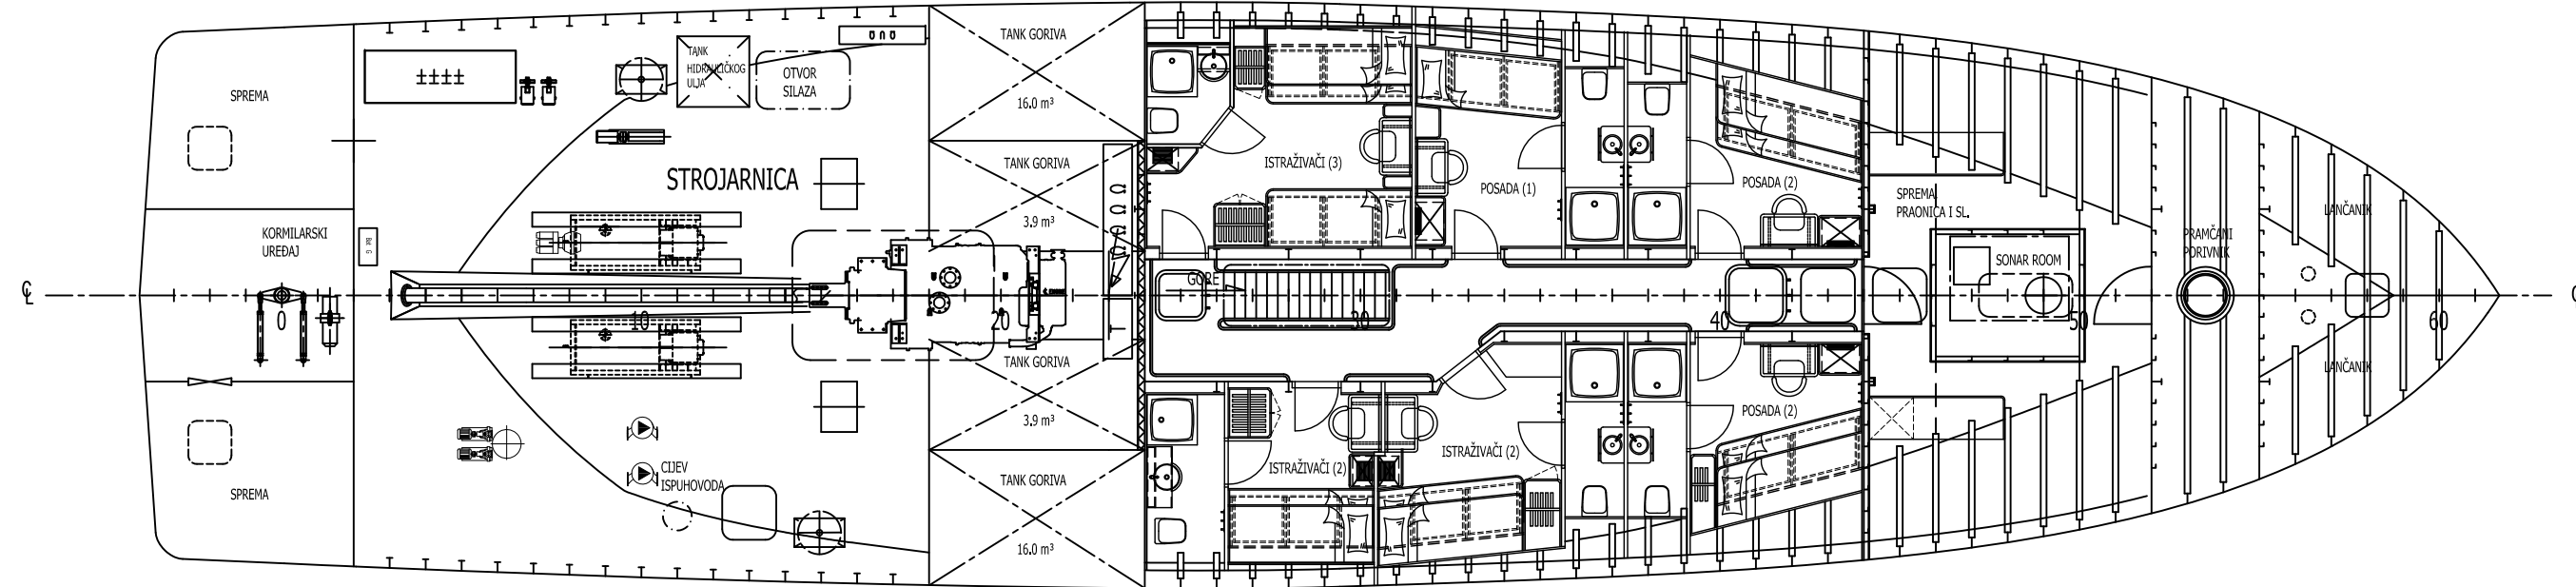

TANKOVI ISPOD DONJE PALUBE

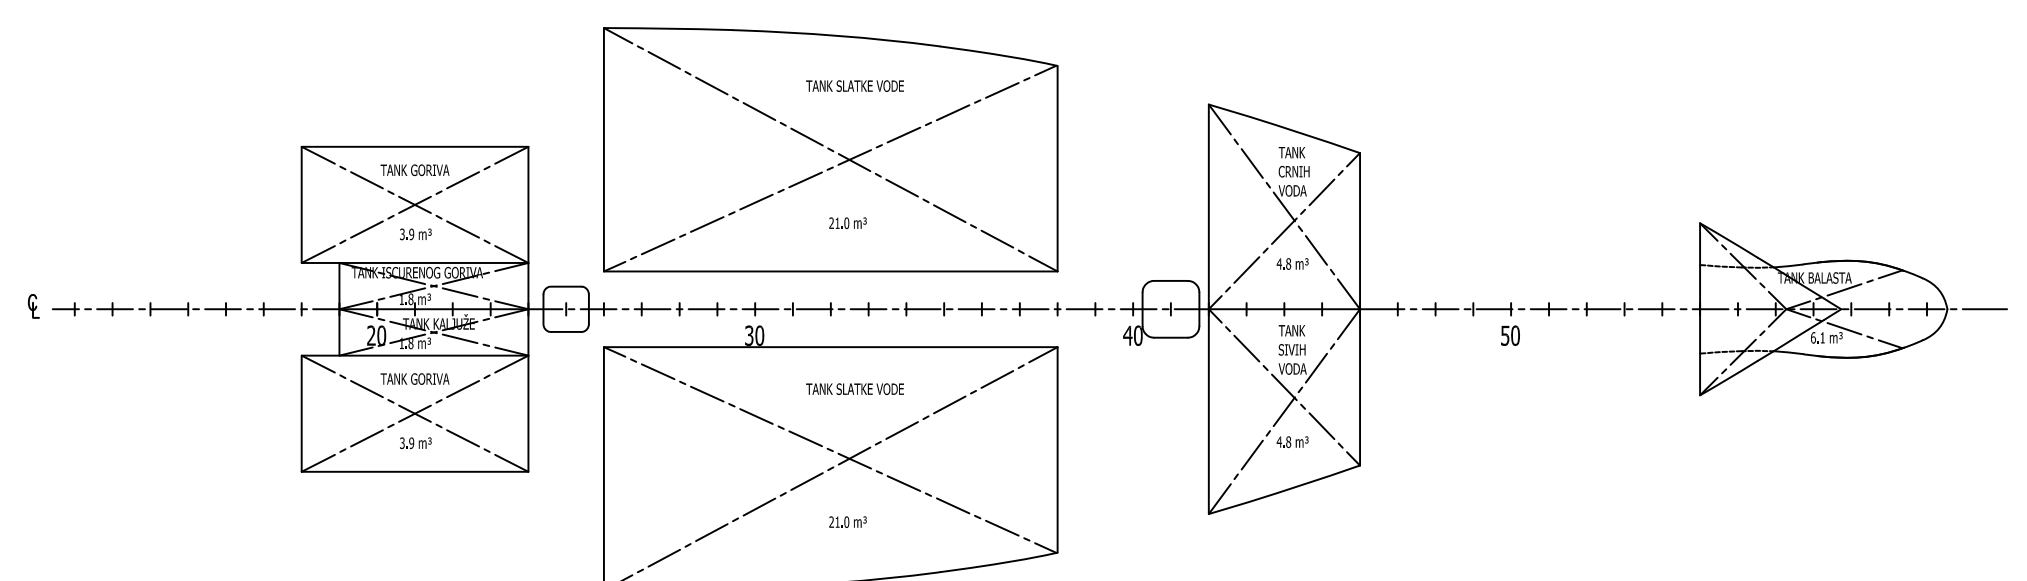

## GLAVNE ZNAČAJKE

Duljina preko svega	36.60 m
Duljina između okomica	29.15 m
Duljina vodne linije	30.88 m
Širina na glavnoj palubi	8.15 m
Visina	4.50 m
Konstruktivni gaz	3.04 m
Istisnina	340 t
Brzina ,pri 85% MCR	12.5 čv
Glavni motor	895 kW @ 1800 rpm
DEA	1 x 125 kW, 1 x 80 kW
Pramčani propulzor	75 kW @ 1081 rpm
Posada	7
Istraživači	17
Klasa	CRS * 100 A1 3 ISTRAŽIVAČKI BROD S, * M1 AUT 3

## MB BIOS DVA

IMO BROJ: 9491185

AS BUILT

Naručilac		Institut za oceanografiju i ribarstvo Split		Graditelj	BRODOSPLIT-BSO
Mjerilo	M 1:100	Masa	Zamjena sa	Objekt: ISTRAŽIVAČKI BROD IB 37	
Datum		2007-06-30		Naziv	
Osnovao:		T. Žužek, di.			
Pregledao:		D. Delajin, di.			
Odobrio:		M. Brik, di.			
c	Izvedeno stanje 2009-06	Kopija		Oznaka naručilca	
b	Izvedeno stanje 2009-05			101-002	
a	Razno 2008-01			Reg. br. 9-4-710	
St. i.	Izmjena	Datum		Oznaka BC-J10-EAM00-000	
				List 1	
				L 1	